


FED. NO.	STATE	PROJECT NO.	COUNTY	SHEET NO.
#	NEVADA	1-580-1(5)1	WASHOE	TC-1

- 1 G20-2 END CONSTRUCTION
- 2 W13-1 ADVISORY SPEED PLATE
- 3 W20-5 RT. LANE CLOSED AHEAD
- 4 W20-5 LT. LANE CLOSED AHEAD
- 5 R1-1 STOP
- 6 W20-7 FLAGMAN AHEAD
- 7 W20-1 ROAD CONSTRUCTION AHEAD
- 8 R11-2 ROAD CLOSED
- 9 R11-3 ROAD CLOSED 1000 FT. AHEAD
- 10 LOCAL TRAFFIC ONLY
- 11 WB-6 TRUCK CROSSING

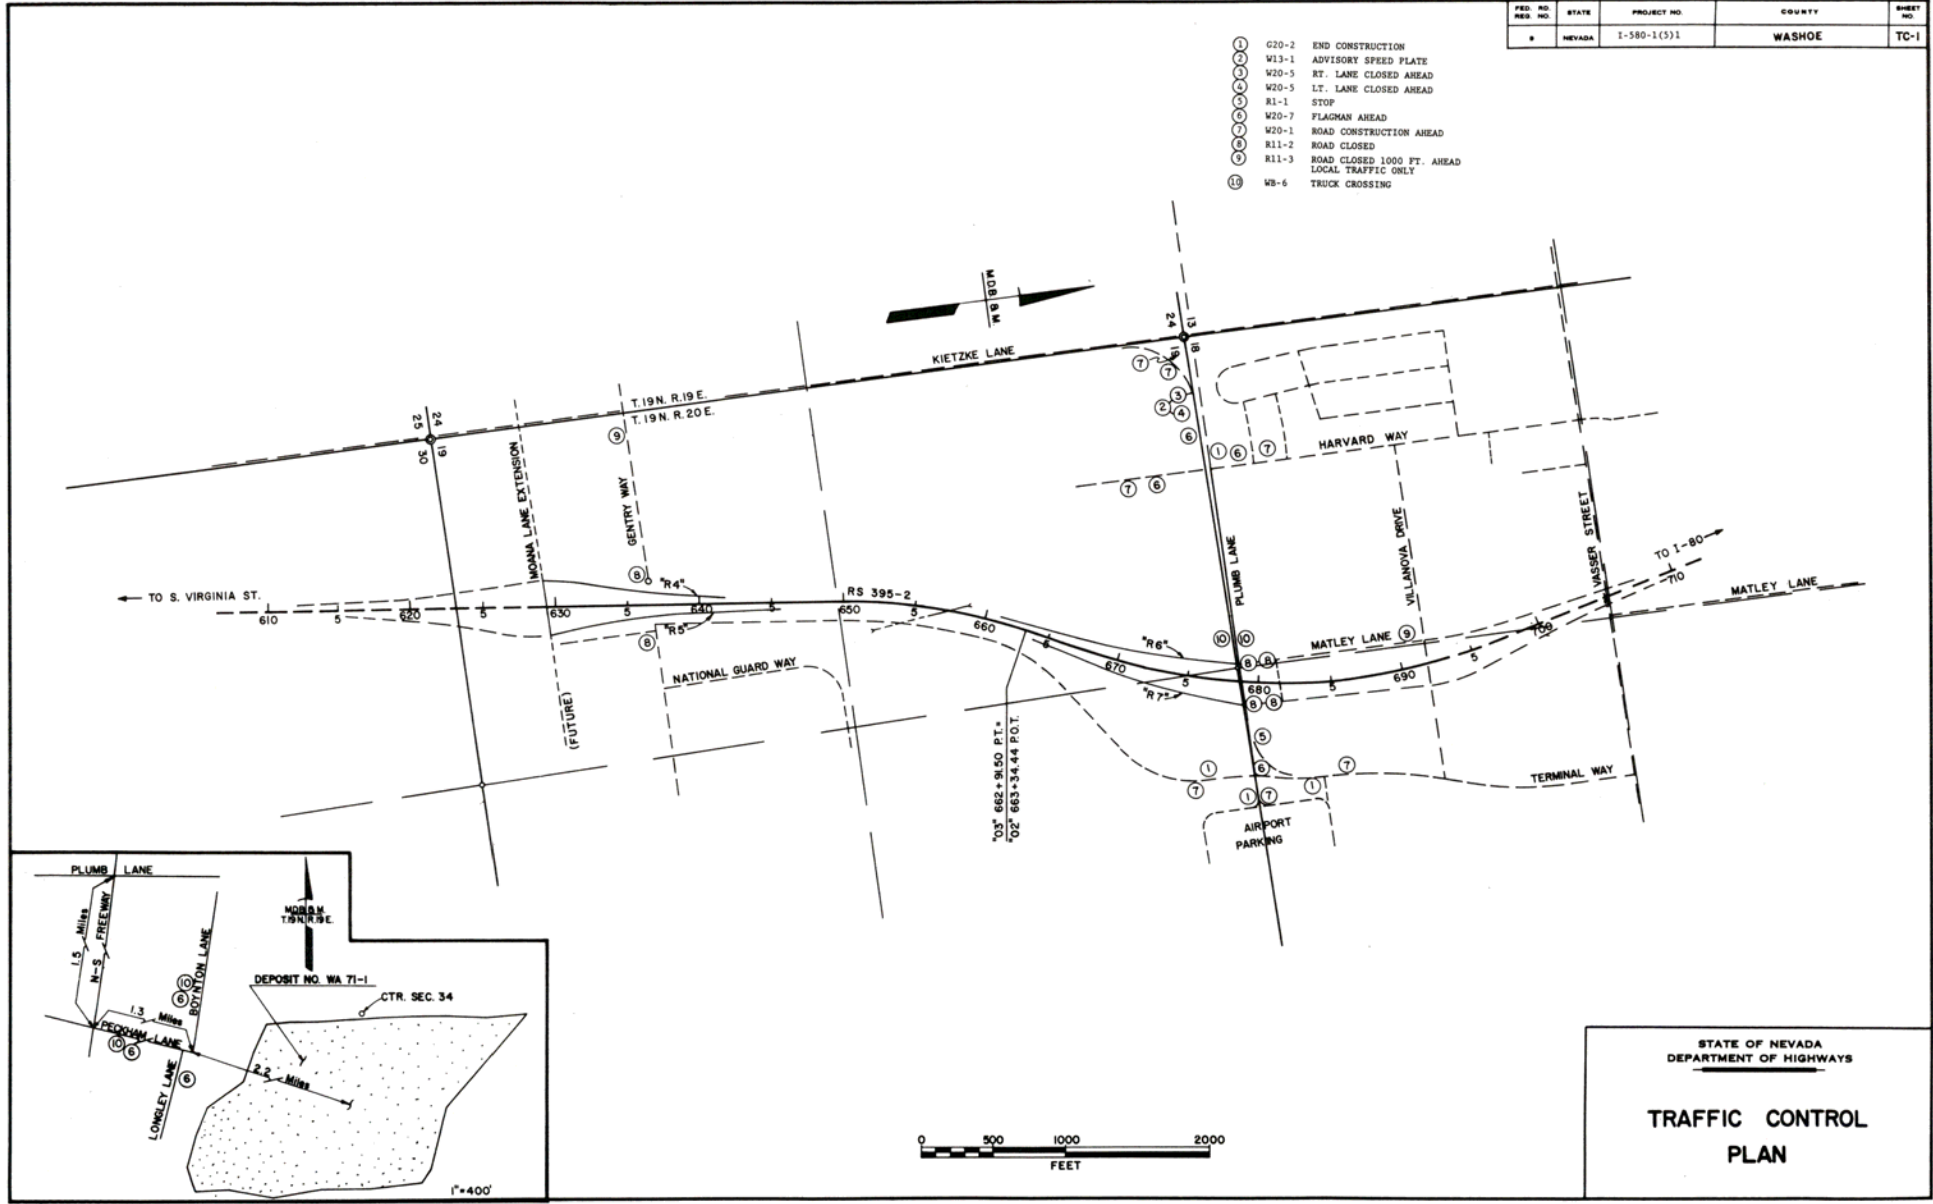

STATE OF NEVADA  
DEPARTMENT OF HIGHWAYS

**TRAFFIC CONTROL  
PLAN**