



FED. RD. DIST. NO.	STATE	PROJECT NO.	COUNTY	SHEET NO.
8	NEVADA	I-580-1(5)1	WASHOE	1A

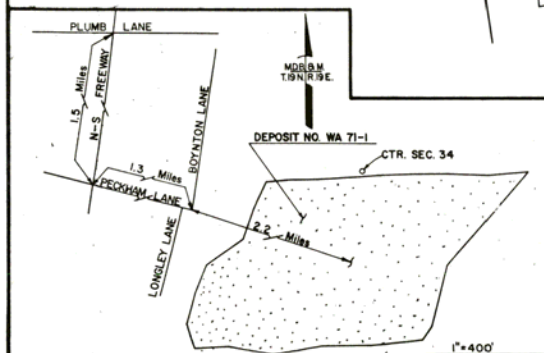

MILEPOST TABULATION

STATION	MILEPOST	DESCRIPTION
"03" 628+50.00 P.O.T.	US 395-WA 22.67	BEGIN PROJECT
"03" 629+38.97 P.O.I.	US 395-WA 22.69	MOANA LN.
"03" 645+73.77 P.O.T.	US 395-WA 23.00	23
"02" 675+00.00 P.O.C.	US 395-WA 23.55	END PROJECT

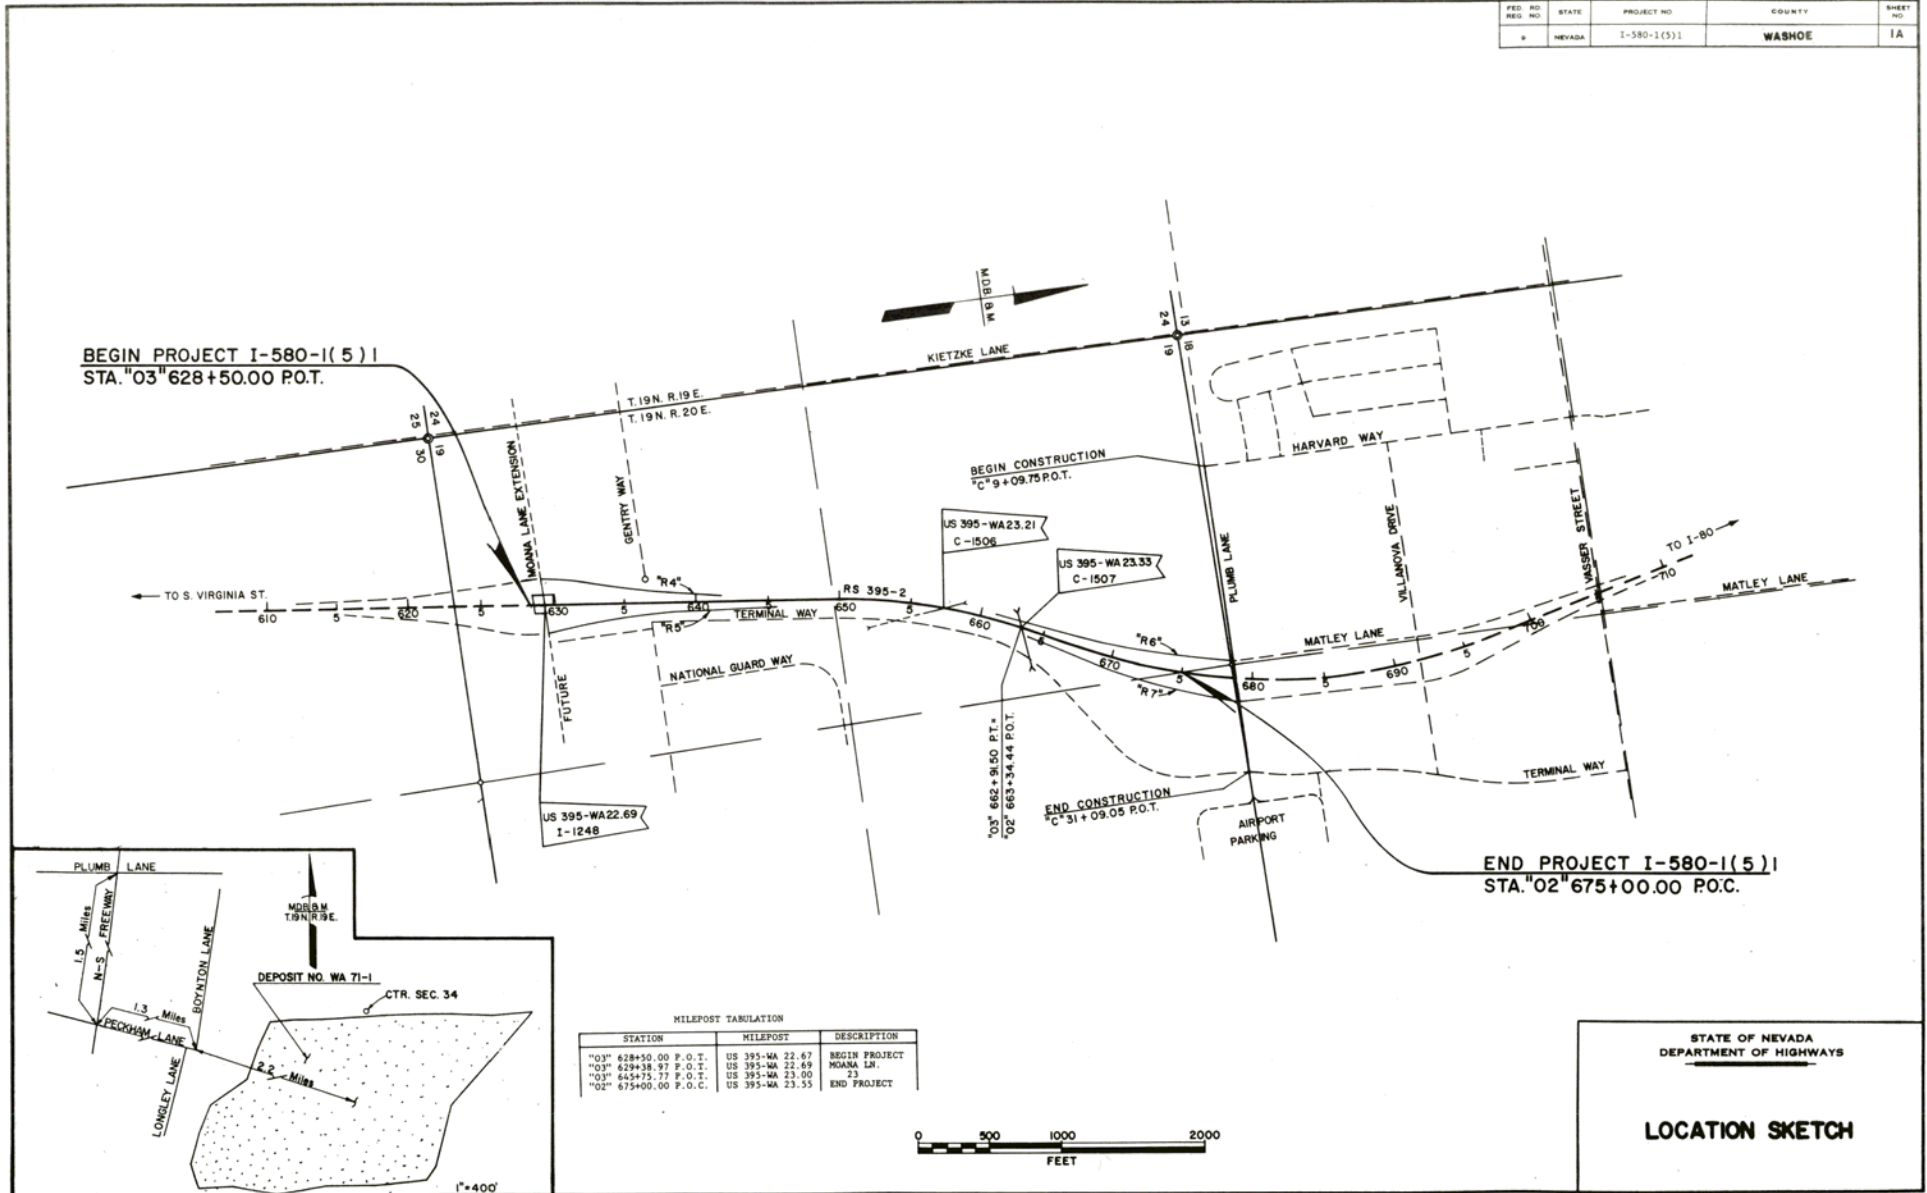

STATE OF NEVADA
 DEPARTMENT OF HIGHWAYS

LOCATION SKETCH