


FED. RD. REG. NO.	STATE	PROJECT NO.	COUNTY	SHEET NO.
9	NEVADA	1-580-1(5)1	WASHOE	2

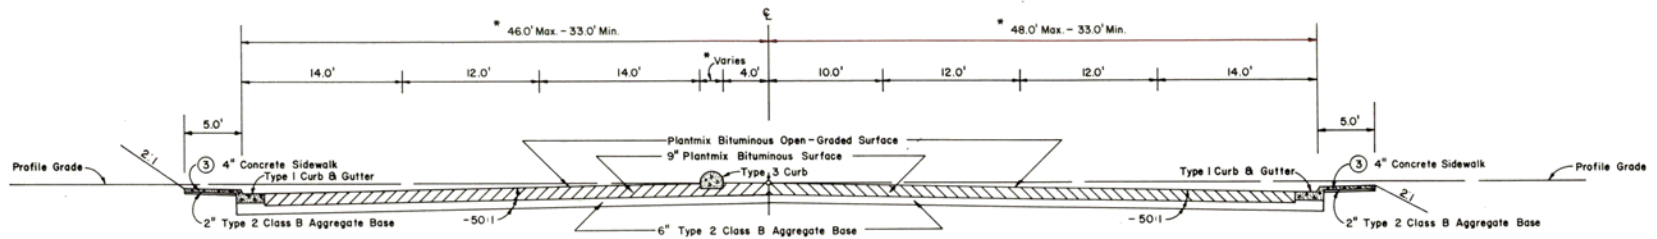


SECTION OF IMPROVEMENT

STA. "ML" 9+27.77 Δ TO STA. "ML" 16+62.39 P.O.T.
(MOANA LANE)


* Note: See Sheet No. 4

③ Note: See Structure List For Exact Location of Sidewalk

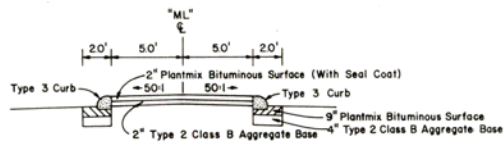

MEDIAN DETAIL

STA. "ML" 8+85.00 P.O.T. TO STA. "ML" 9+27.77 Δ

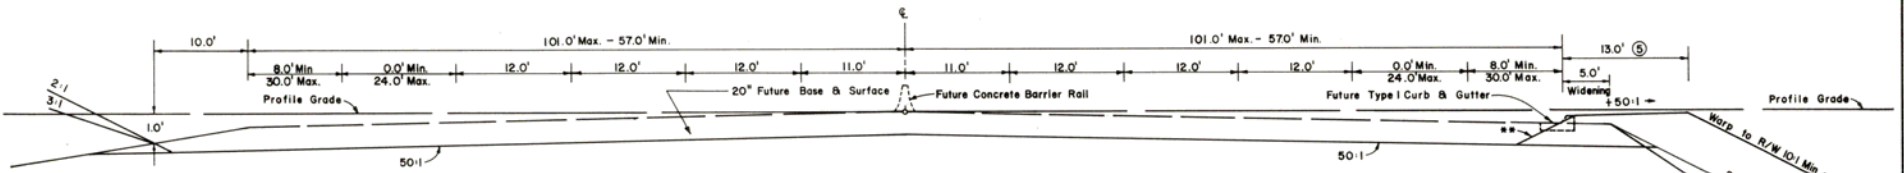


SECTION OF IMPROVEMENT

CONSTRUCTION TYPE CODE 1010

S.T.A. "03" 628 + 50.00 P.O.T. TO STA. "03" 640 + 00.00 P.O.T.
S.T.A. "03" 652 + 00.00 P.O.C. TO STA. "02" 675 + 00.00 P.O.C.

** Angle of Repose
⑤ STA. "03" 637 + 40.10 P.O.T. TO STA. "03" 639 + 50.00 P.O.T.


FED. RD. REG. NO.	STATE	PROJECT NO.	COUNTY	SHEET NO.
9	NEVADA	T-590-1(5)1	WASHOE	2A

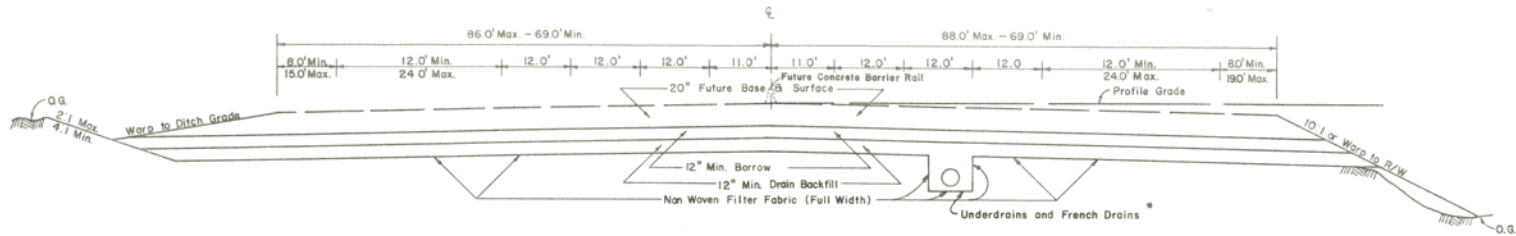


SPECIAL SECTION OF IMPROVEMENT

CONSTRUCTION TYPE CODE 1010
 STA. "03" 640+00.00 P.O.T. TO STA. "03" 652+00.00 P.O.C.



* Sta. "03" 645+00.00 P.O.T. TO STA. "03" 652+00.00 P.O.C.

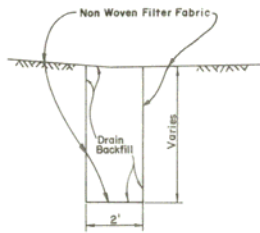

SECTION B-B

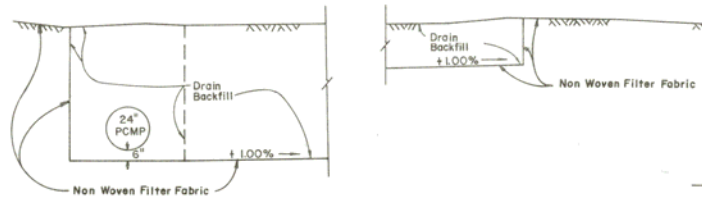

SECTION A-A

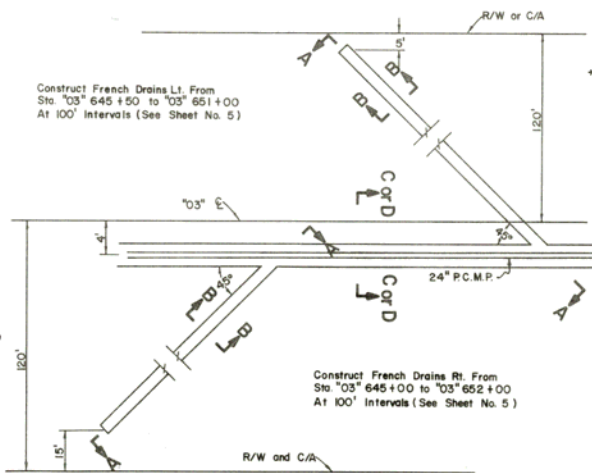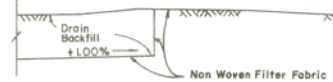


Construct French Drains Lt. From Sta. "03" 645+50 to "03" 651+00 At 100' Intervals (See Sheet No. 5)

Construct French Drains Rt. From Sta. "03" 645+00 to "03" 652+00 At 100' Intervals (See Sheet No. 5)

PLAN


FRENCH DRAINS

NOTE: Place Nonwoven Filter Fabric on Bottom and Sides of Trenches Only

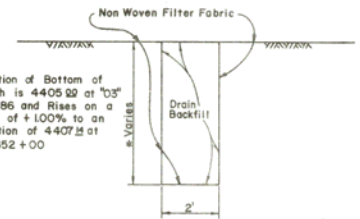

SECTION D-D


* Elevation of Bottom of Trench is 4405.29 at "03" 649+86 and Rises on a Grade of +1.00% to an Elevation of 4407.21 at "03" 652+00
 4' Rt. of "03" 649+81 to 4' Rt. of "03" 652+00
 110' Lt. "03" 630+45 to 110' Lt. of "03" 631+50

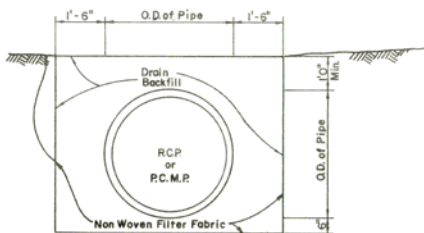

SECTION C-C


* 115' LT. TO 150' RT. OF "03" 630+50
 * 4' RT. OF "03" 640+00 TO 4' RT. OF "03" 649+81
 * 85' LT. TO 4' RT. OF "03" 645+00
 * 115' LT. TO 4' RT. OF "03" 646+90
 * 100' LT. TO 110' RT. OF "03" 649+81
 * OTHER LOCATIONS AS DIRECTED BY THE ENGINEER.

* OPEN JOINT PIPE CONSTRUCTION

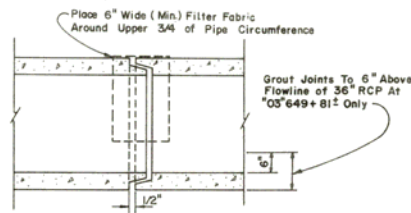


STATE OF NEVADA
 DEPARTMENT OF HIGHWAYS
 TYPICAL SECTION
 &
 SPECIAL DETAILS

FED. RD. REG. NO.	STATE	PROJECT NO.	COUNTY	SHEET NO.
9	NEVADA	I-580-1(3)	WASHOE	2B

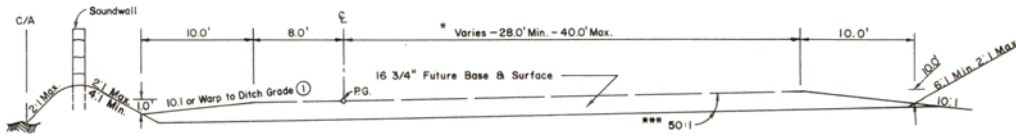


SECTION OF IMPROVEMENT
RAMP 4
STA. "R4" 0+46.03 P.O.T. TO STA. "R4" 8+18.44 P.O.C.


- * Varies See Sheets No. 4 Thru 7
- ** Angle of Repose
- *** Cross Slope Varies See Sheets No. 4 Thru 16
- ① See Sheet No. 10, 13, & 16

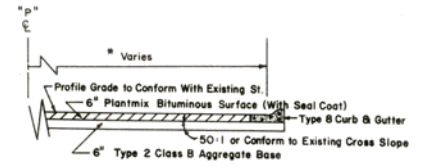


SECTION OF IMPROVEMENT
CUL - DE - SAC
(ENTRYWAY)
STA. "P" 3+23.81 P.O.T. TO STA. "P" 4+46.00 P.O.T.

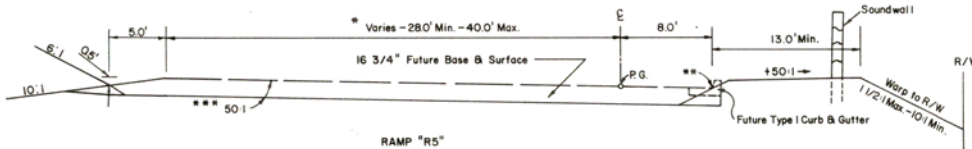


SECTION OF IMPROVEMENT
RAMP "R5"
STA. "R5" 0+46.16 P.O.T. TO STA. "R5" 7+89.81 P.O.C.

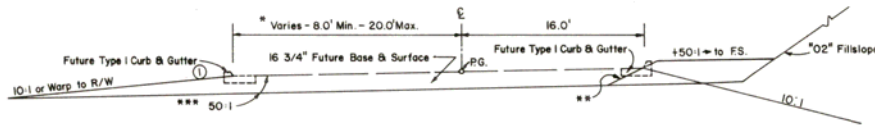

SECTION OF IMPROVEMENT
RAMP "R6"
STA. "R6" 11+92.23 P.O.T. TO STA. "R6" 23+86.66 P.O.T.

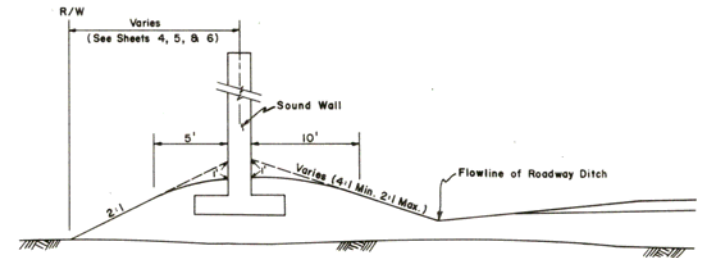


SOUND WALL BERM
See Sheet No 28 Thru 49

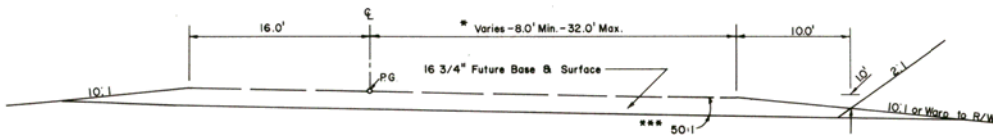

SECTIONS OF IMPROVEMENT
RAMP "R7"
STA. "R7" 2+51.61 P.O.T. TO STA. "R7" 15+56.11 P.O.T.


STATE OF NEVADA
DEPARTMENT OF HIGHWAYS
**TYPICAL SECTIONS
&
SPECIAL DETAIL**

FED. RD. REG. NO.	STATE	PROJECT NO.	COUNTY	SHEET NO.
9	NEVADA	I-580-1(5)1	WASHOE	2C

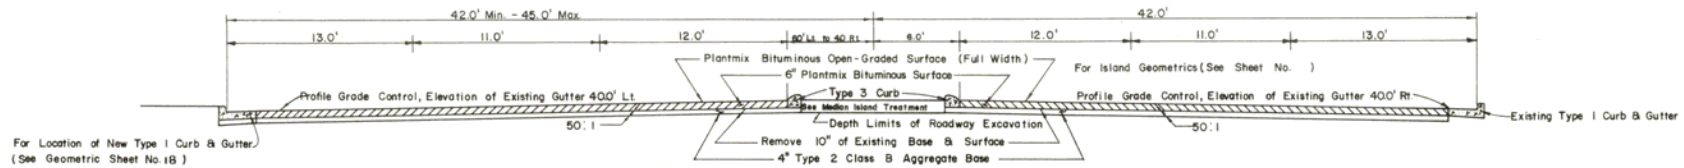


SECTION OF IMPROVEMENT

"C"9+09.75 POT. to "C"21+50.00 POT.
 "C"28+54.00 POT. to "C"29+64.00 POT.

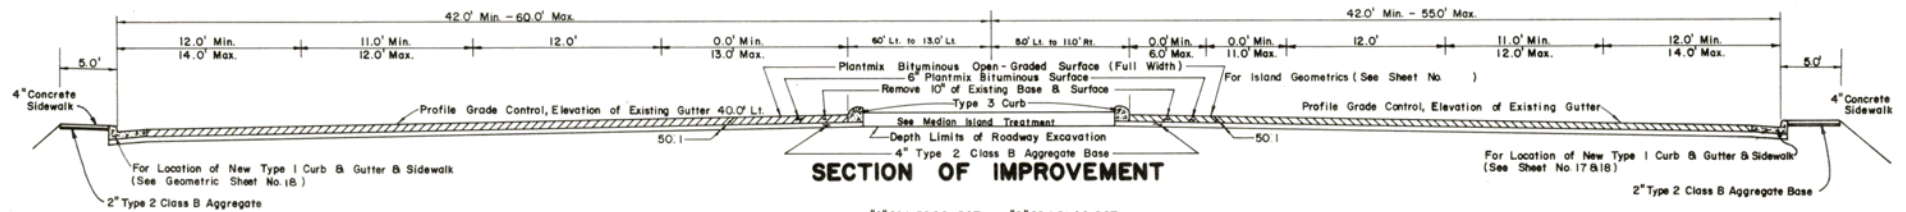



SECTION OF IMPROVEMENT

"C"21+50.00 POT. to "C"28+54.00 POT.

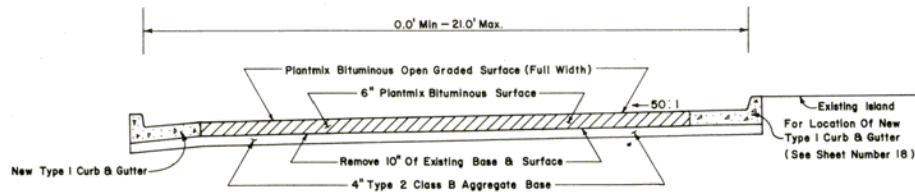

SECTION OF IMPROVEMENT

Terminal Way to E. Plumb Lane Rt. Turn Lane

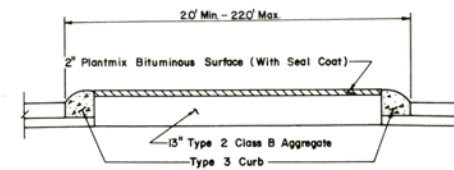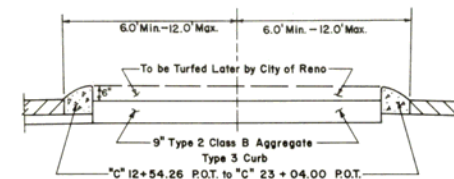

"C"9+60.25 POT. to "C"12+54.26 POT.
 "C"23+92.00 POT. to "C"25+70.00 POT.
 "C"26+48.00 POT. to "C"30+59.00 POT.

MEDIAN ISLAND TREATMENT